

REQUEST FOR INFORMATION NOT ADDRESSED IN THIS CCO REMAIN IN FORCE						
0	03/08/10	MEP INTEGRATION	SYC	FW	110	
MARK	DATE	DESCRIPTIONS	BY	CH'D	CCO#	
REVISIONS						

CONTRACT CHANGE ORDER NO. _____
SHEET _____ OF _____



DIST	COUNTY	ROUTE	KILOMETER TOTAL PROJECT	POST TOTAL PROJECT	SHEET No	TOTAL SHEETS
04	SF, Alameda	80	12.2/14.3	0.0/4.0	407a 06S22	1204

Syn Yee Chin

03/08/10

REGISTERED ELECTRICAL ENGINEER

DATE

05-06-2010

PLANS APPROVAL DATE

PB AMERICAS, Inc.

A Parsons Brinckerhoff Company

303 Second St., Suite 700N

San Francisco, CA 94107-1317

REGISTERED PROFESSIONAL ENGINEER

SYN YEE CHIN

No. 18186

Exp. 09/30/2011

ELECTRICAL


STATE OF CALIFORNIA

The State of California or its officers or agents shall not be responsible for the accuracy or completeness of electronic copies of this plan sheet.

Caltrans now has a web site. To get to the web site, go to <http://www.dot.ca.gov>

- NOTES:
- This plan sheet is a record drawing from Oakland Touchdown 1 contract. The Contractor shall verify the existing installation. See sheet E-81 of Oakland Touchdown 1, contract No. 04-0120L4.
 - The Installed components shall not be limited to the ones listed below, but shall be a complete installation. For details, see Bridge Structures Girder Westbound, typical Details sheets.
 - Furnish and install (4) one-inch inner-ducts with TOS fiber optic cables in one inner-duct, into existing conduit shown on this drawing. Refer to riser diagram on sheets E-978 through E-981 and detail on E-973.
 - All conduits shown on this drawing are existing. Bold ones are to be used for pulling cable.

- SHEET NOTES:
- For details on racking TOS fiber inside manhole, see E-663A, Detail 3.
 - Cross section reference for conduit configuration.

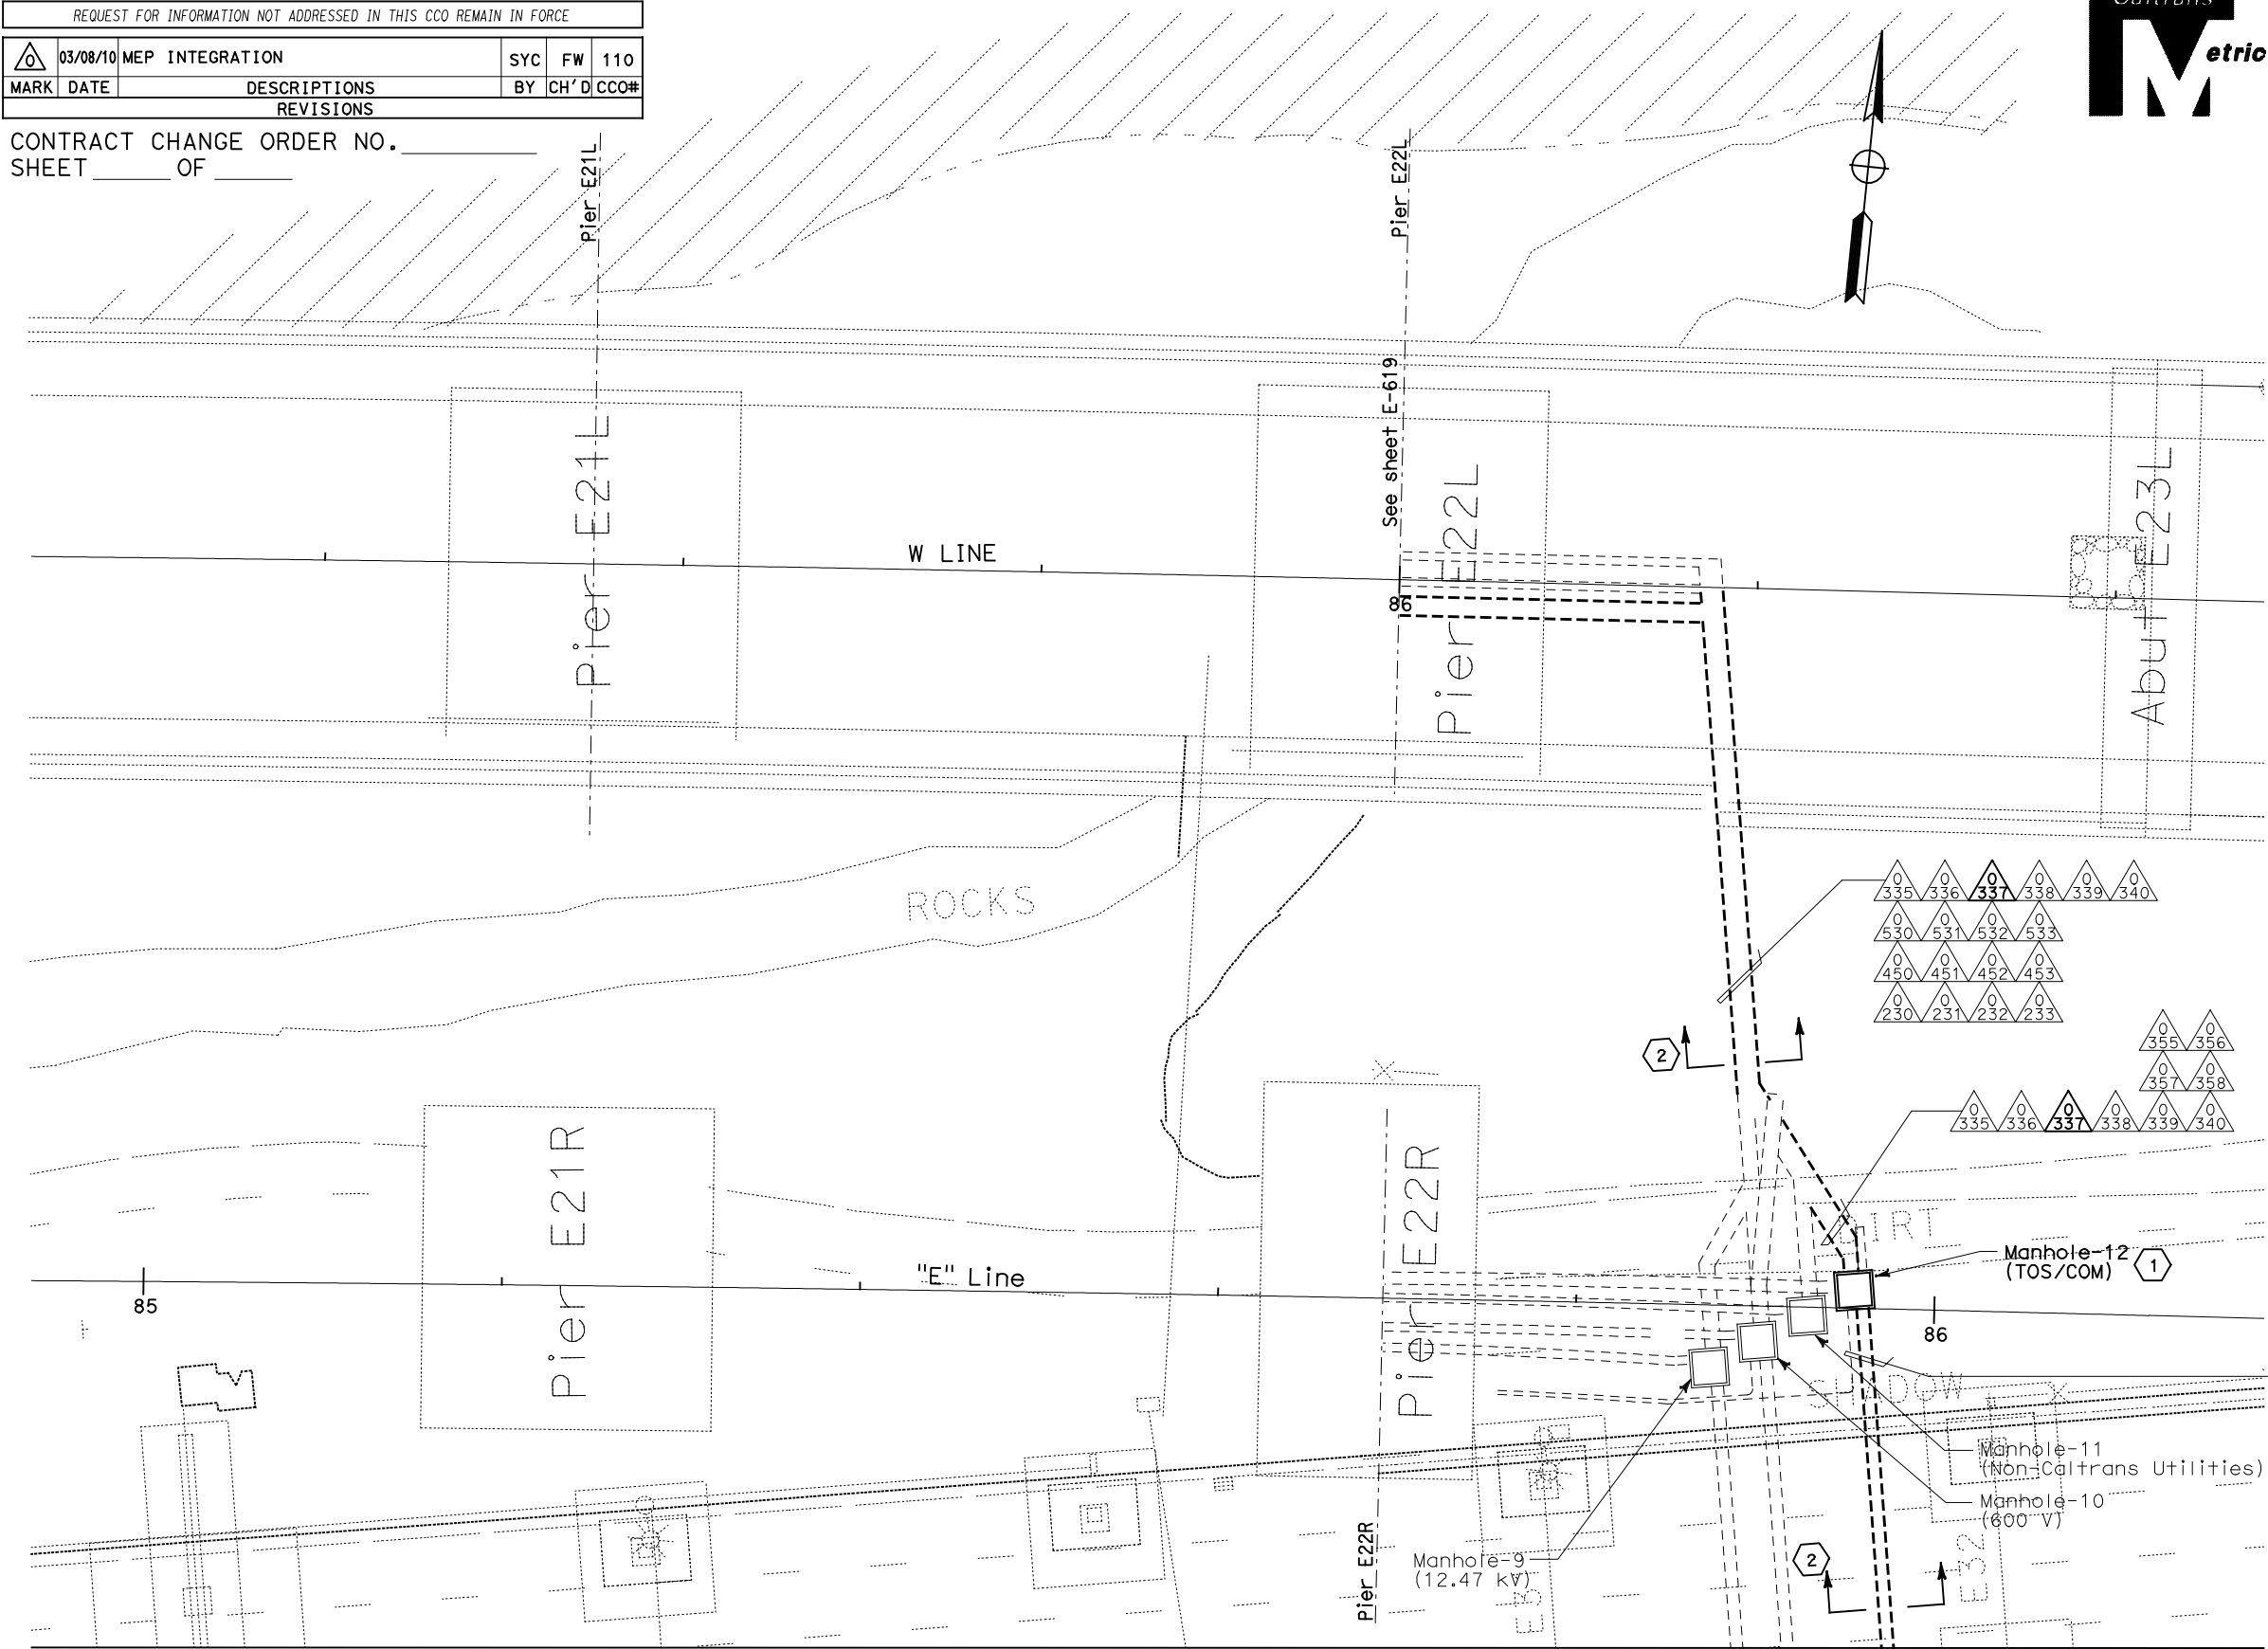

See sheet E-622


BRIDGE STRUCTURES GIRDER WESTBOUND
OAKLAND APPROACH STRUCTURES
UNDERGROUND
SCALE: 1:200

PLAN

THIS PLAN ACCURATE FOR ELECTRICAL WORK ONLY.

ALL DIMENSIONS ARE IN METERS UNLESS OTHERWISE SHOWN

FOR REDUCED PLANS ORIGINAL SCALE IS IN MILLIMETERS

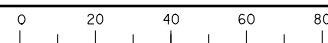

DGN FILE => 04-0120f1_E-621.dgn
USERNAME => ilorico